


PRIOR TO 1/15/08 (REV J)

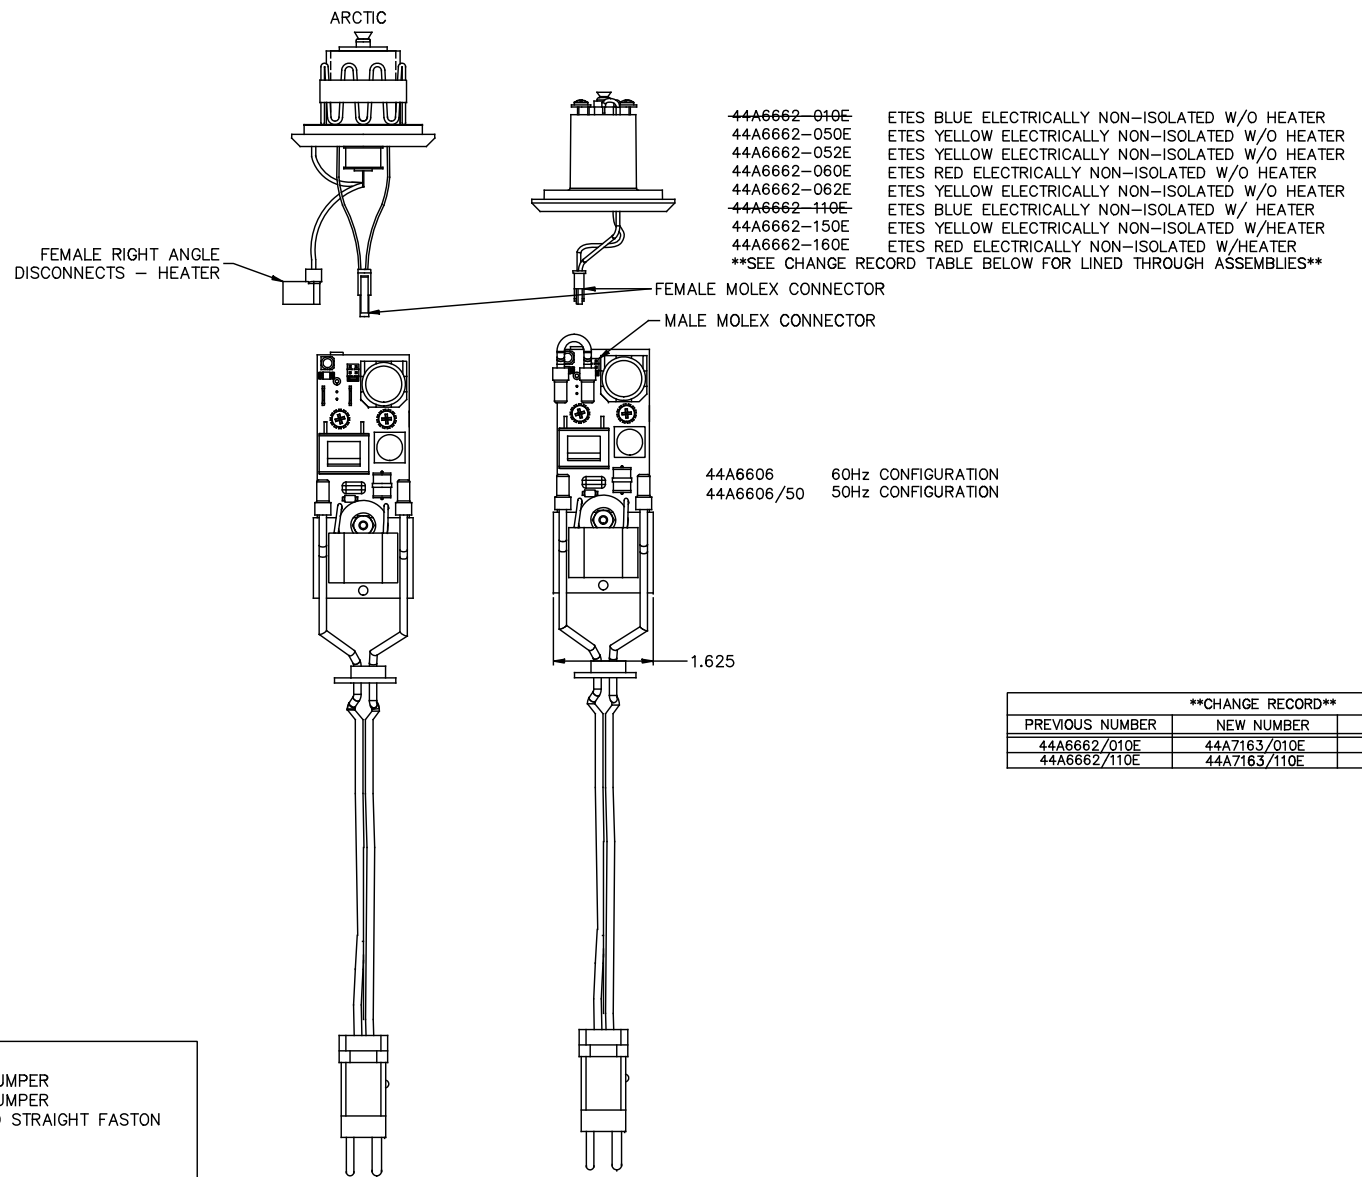

94A0505 KIT, FEMALE TO FEMALE MOLEX JUMPER
 94A0505/1 KIT, FEMALE TO FEMALE MOLEX JUMPER
 PLUS FEMALE TO FEMALE FLAG TO STRAIGHT FASTON

AFTER 1/15/08 (REV J)

****CHANGE RECORD****

PREVIOUS NUMBER	NEW NUMBER	ECO#/DATE
44A6662/010E	44A7163/010E	3265 / 18MAY11
44A6662/110E	44A7163/110E	3265 / 18MAY11

CONTROLLED COPY			
Unauthorized duplication of this document in whole or part is prohibited. Initialed in RED Ink below indicates authorized copy.			
APPRVD BY:		DATE:	
ADB A Siemens Company			
PROJECT TITLE:			
DRAWING TITLE: ETES RETROFIT DETAILS FOR REV J CHANGE (1/15/08)			
B	3265	SEE EC	JEG 16AUG11
A	----	PROD. RELEASE	DLR 14OCT10
REV LEVEL	ECO NUMBER	REVISION DESCRIPTION	DRAWN BY REV DATE
			DLR 14OCT10
ASSOCIATED DRAWINGS:			DRAWN DATE:
			14OCT10
Information contained on this drawing is to be used expressly in accord with purpose for which it was submitted. Any disclosure of this information is strictly prohibited except as ABB-ALNAD may otherwise agree in writing.			DRAWING NUMBER: 117A0061
Copyright © [1997] ABB A Siemens Company			1 OF 1 SCALE: 1 = 1 REV: B